

STATE OF UTAH
DEPARTMENT OF NATURAL RESOURCES
DIVISION OF OIL, GAS AND MINING
 1594 West North Temple - Suite 1210
 Box 145801
 Salt Lake City, Utah 84114-5801
 Telephone: (801) 538-5291
 Fax: (801) 359-3940

LARGE MINING OPERATIONS PROGRESS REPORT

January 1, 20 12 to December 31, 20 12

The information required in this form is based on provisions of the Mined Land Reclamation Act, Title 40-8, and the R647 rules under the Utah Minerals Regulatory Program. It is due January 31 of each year.

1. Mine Permit Number: M 490086
2. Mine Name: Lincoln Pit
3. Name of Operator/Permittee: Ames Construction Inc.
 Note: If Operator's address, company representative or phone number have changed, please provide a replacement page for the Notice of Intention together with form MR-REV available on the Division's web page at https://fs.ogm.utah.gov/pub/mines/minerals_related/forms/MR-REV.pdf.
4. Report the gross amount of ore mined and waste moved:
 Gross Ore Mined 8,188 Tons, or — yd³
 Waste Material Moved 0 Tons, or — yd³
5. New disturbance created during the year 0 Acres
 Area reclaimed during the year 11 Acres
 Total disturbed area at the end of the year 38.2 Acres*
 *The total disturbed area should not be greater than the permitted/bonded acreage
6. Briefly describe the reclamation work performed during the past year. (Submit form MR-SITE (https://fs.ogm.utah.gov/pub/mines/minerals_related/forms/MR-SITE.pdf) to apply for full or partial bond/site release). Attach additional sheets if needed.
See Attached Sheet
7. Include an updated map depicting surface disturbance and reclamation performed during the year (Rule R647-4-105).

I hereby certify the information provided in this report is true and correct to the best of my knowledge and belief.


Name (Typed or Print): Leonard Botelho
 Title of Operator: SR. Manager
 Signature of Operator: [Signature]
 Date: 1/30/13

Permit # M/049/0086 – Lincoln Pit 2012 Annual Report – Additional Sheet


6. During October of 2012, Approximately 11 acres of the northwest corner of the project area was reclaimed. This area was disturbed as a result of exploration activity. The exploration determined that the area does not contain an aggregate resource.


Ames is not seeking surety bond reduction at this time as this area was originally designed as part of the pit/mine area. For the pit/mine area, the surety earthwork sheets assume concurrent 2H:1V slope grading therefore the 11-acre reclamation was not accounted for other than a negligible top soil placement volume value which Ames is not seeking release. In three years, assuming vegetal establishment is successful, Ames will then request an \$11,000 (\$1,000/AC) release. Consequently, Form MR-Site/Bond Release is not being submitted at this time.

MINE DISTURBANCE PLAN

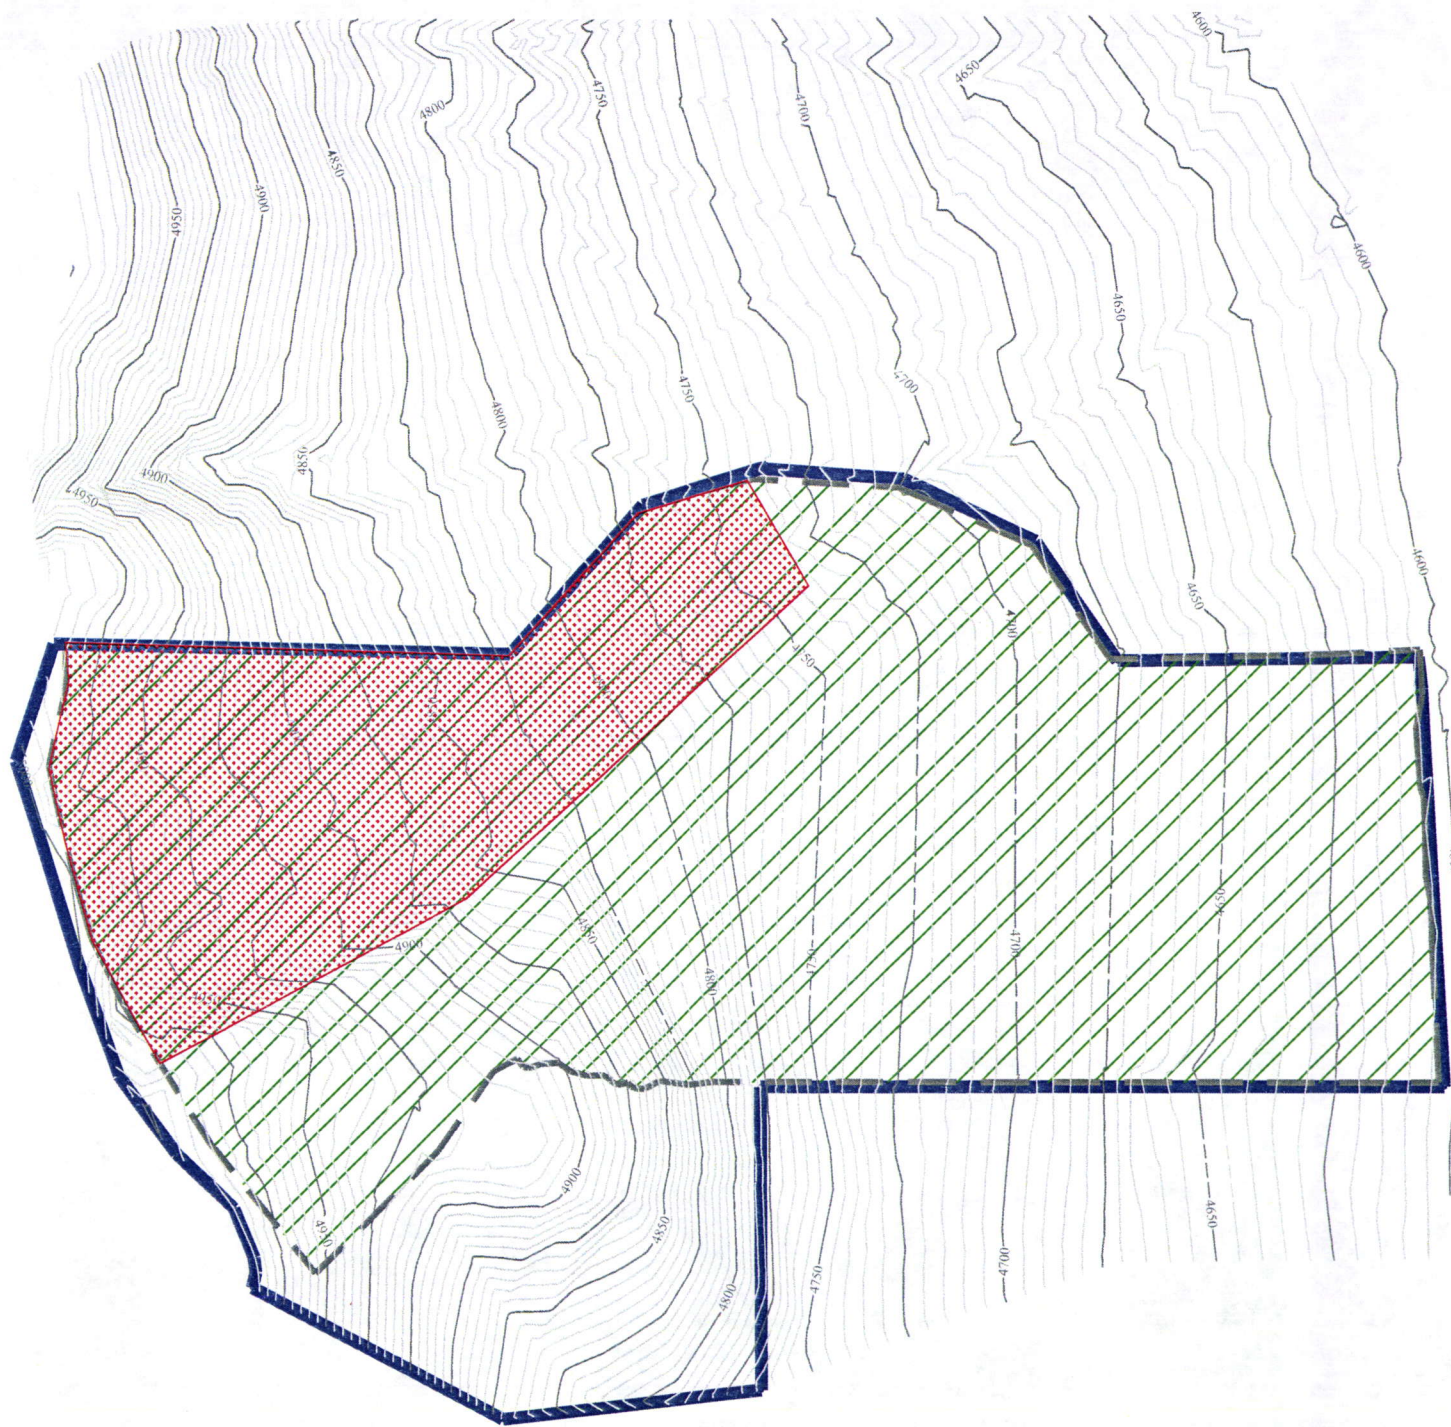


LEGEND

 DISTURBED AREA AS OF 12-31-2012

 RECLAIMED AREA AS OF 12-31-2012

 EXISTING CONTOURS

QUANTITY TABLE	
TOTAL DISTURBED AREA	38.2 ACRES
RECLAIMED AREA	11 ACRES


SCALE 1"=300'

5			DESIGNED BY:		DATE:
4			DRAWN BY:		DATE: 1-22-2013
3			CHECKED BY:		DATE:
2			APPROVED BY:		DATE:
1			COGO FILE:		DATE:
NO.	REVISIONS	BY	DATE	REV. COGO FILE:	DATE:

LINCOLN QUARRY
DOGM ANNUAL REPORT
#M490086

MINE DISTURBANCE PLAN
FIGURE 1
LINCOLN PIT PROPERTY PAYSON, WEST MOUNTAIN

UTAH COUNTY, UTAH

 **Ames Construction, Inc.**

3737 WEST 2100 SOUTH
WEST VALLEY CITY,
UTAH 84120
801-977-8012

JOB NO.
SHEET NO.
1 of 1



Ames Construction, Inc.

3737 West 2100 South
West Valley City, UT 84120
801-977-8012 • Fax 801-977-8088



January 30, 2013

104507-AC(LP)-DOGM-L001

Paul Baker, Minerals Program Manager
Utah Department of Natural Resources
Division of Oil, Gas & Mining
1594 West Temple Suite 1210
Salt Lake City, Utah 84114-5801

By: *Hand Delivery*

**Re: Permit # M/049/0086 – Lincoln Pit
2012 Annual Report - Transmittal**

Dear Mr. Baker:

Ames Construction, Inc. (Ames) hereby submits the 2012 Annual Report pursuant to Permit #M/049/0086. Attached is **Figure 1 - Mine Disturbance Plan**, which depicts the 2012 disturbance.

Enclosed is check #398460 to cover the \$500 annual fee.

Don't hesitate to contact me if you have any comments or questions pertaining to the contents of the annual report being submitted.

Sincerely,

Christopher Ennes
Environmental Manager

Enclosures

cc: Permit File

RECEIVED

JAN 30 2013

DIV. OF OIL, GAS & MINING

An Equal Opportunity Employer

OFFICE IN: PHOENIX, ARIZONA • AURORA, COLORADO • BURNSVILLE, MINNESOTA • CARLIN, NEVADA